



Colliers International
1850 Mount Diablo Boulevard, Suite 200
Walnut Creek, CA 94596 | United States
www.colliers.com

LEASING AGENT

Scott Ellis
(925) 279-5575

scott.ellis@colliers.com

Matt Hurd
(925) 279-5567

matt.hurd@colliers.com

Eric Erickson
(925) 279-5580

eric.erickson@colliers.com

METROPLEX CENTRE

1401 Willow Pass Road
Concord, CA

Ninth Floor

Owned and Managed by

**Sierra Pacific
Properties, Inc.**


Approximate Area Calculations
Subject To Verification:

24,264 rsf

As-built Plan To Be Verified

This information displayed while not guaranteed has been secured by sources we believe to be reliable. This information is subject to errors & omissions. Any tenant should conduct their own investigation.

Plan Revision - 11-16-22

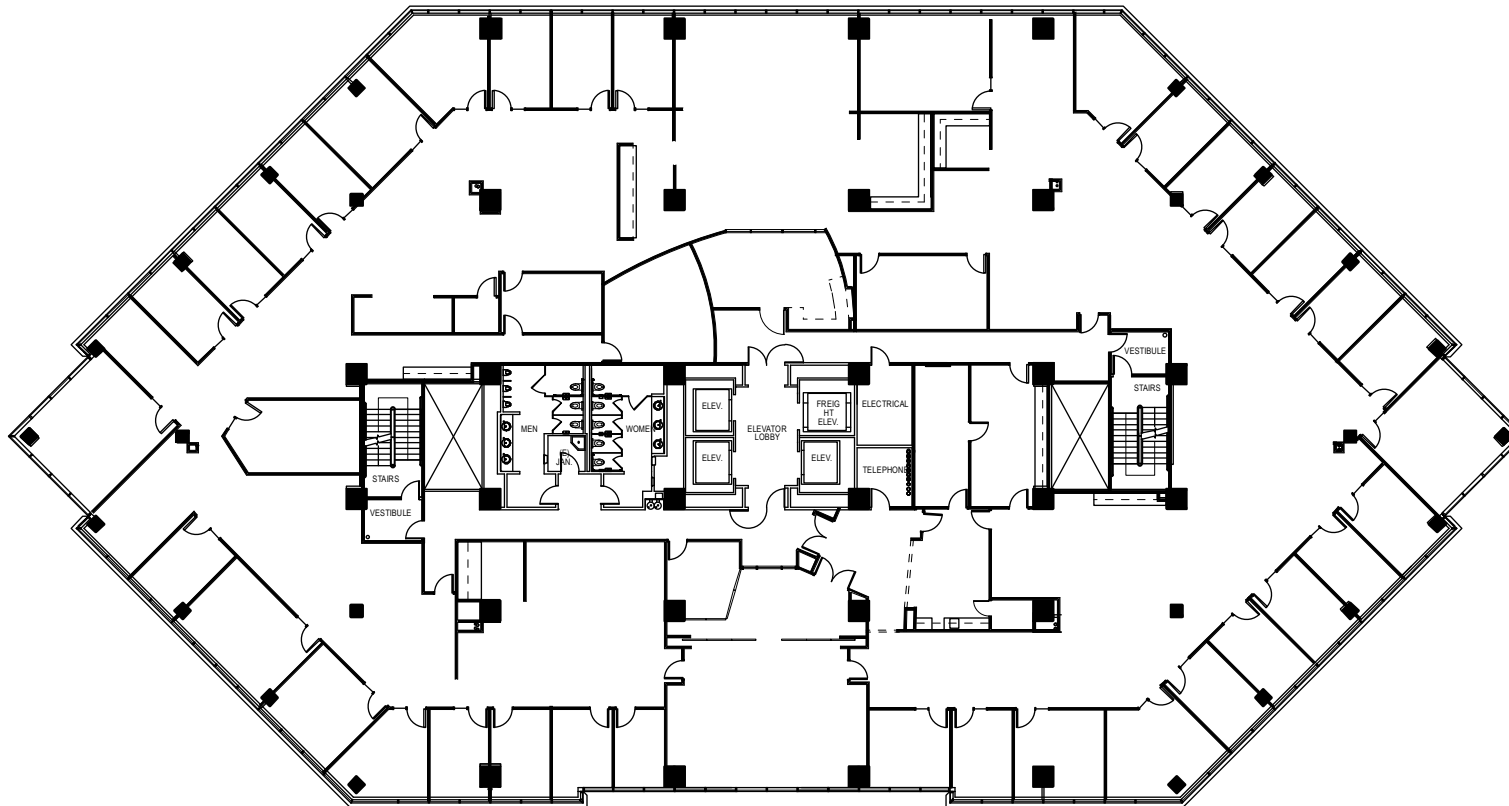

Ninth Floor