



SECOND FLOOR KEY PLAN

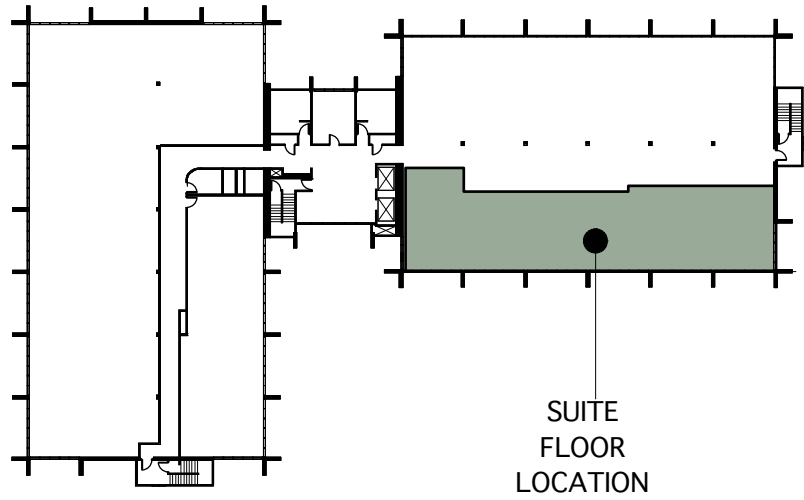

SUITE 200

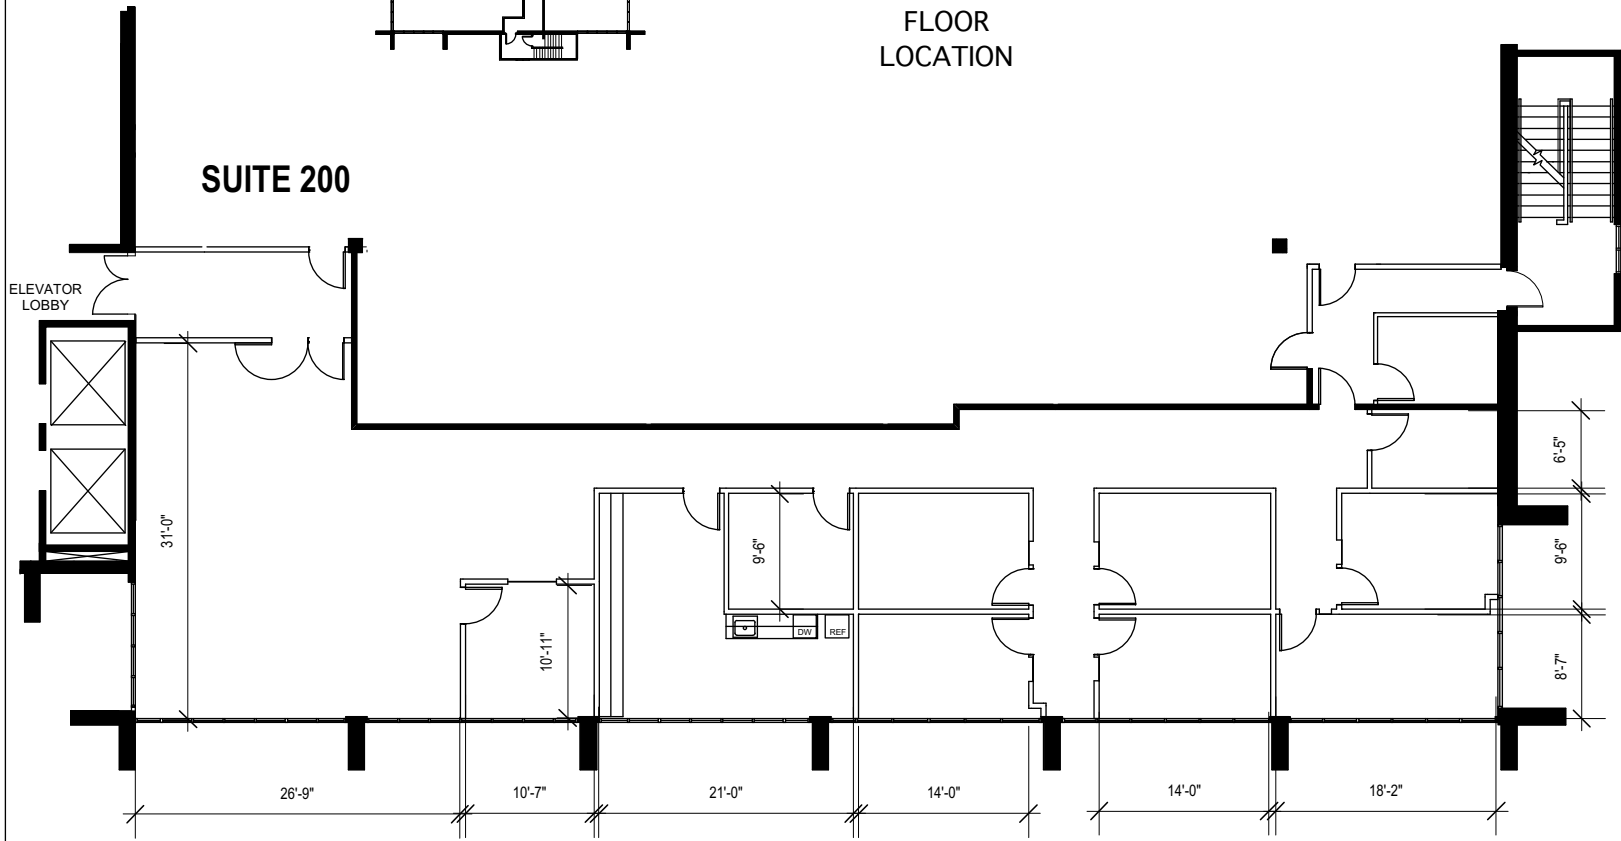

Colliers International
 1850 Mount Diablo Boulevard, Suite 200
 Walnut Creek, CA 94596 | United States
 www.colliers.com

LEASING AGENT

Scott Ellis
 (925) 279-5575

scott.ellis@colliers.com

Matt Hurd
 (925) 279-5567

matt.hurd@colliers.com

Buskirk Executive Center

2950 Buskirk Ave
 Walnut Creek, CA 94597

Second Floor

Owned and Managed by

Cranbrook Group, Inc.

Approximate Area Calculations
 Subject To Verification:

3,477 rsf

As-built Plan To Be Verified

This information displayed while not guaranteed has been secured by sources we believe to be reliable. This information is subject to errors & omissions. Any tenant should conduct their own investigation.

Plan Revision - 12-6-18