

LEASING AGENT

Scott Ellis
(925) 279-5575

scott.ellis@colliers.com

Matt Hurd
(925) 279-5567

matt.hurd@colliers.com

Eric Erickson
(925) 279-5580

eric.erickson@colliers.com

Gateway Centre

1850 Mt. Diablo Blvd.
Walnut Creek, CA 94596

Third Floor

Owned and Managed by

**Sierra Pacific
Properties, Inc.**


Approximate Area Calculations
Subject To Verification.

2,543 rsf


As-built Plan To Be Verified

This information displayed while not guaranteed has
been secured by sources we believe to be reliable.
This information is subject to errors & omissions.
Any tenant should conduct their own investigation.

Plan Revision - 9-21-21

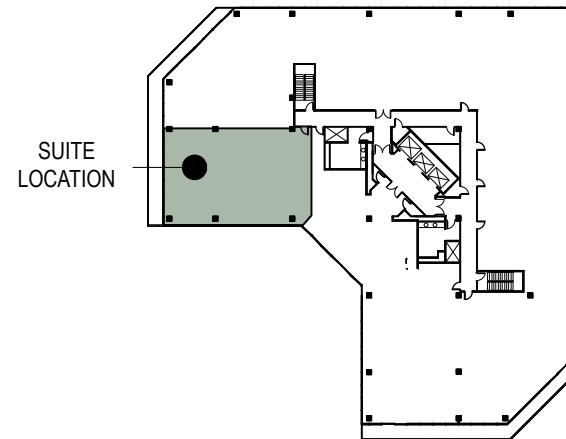

THIRD FLOOR KEY PLAN

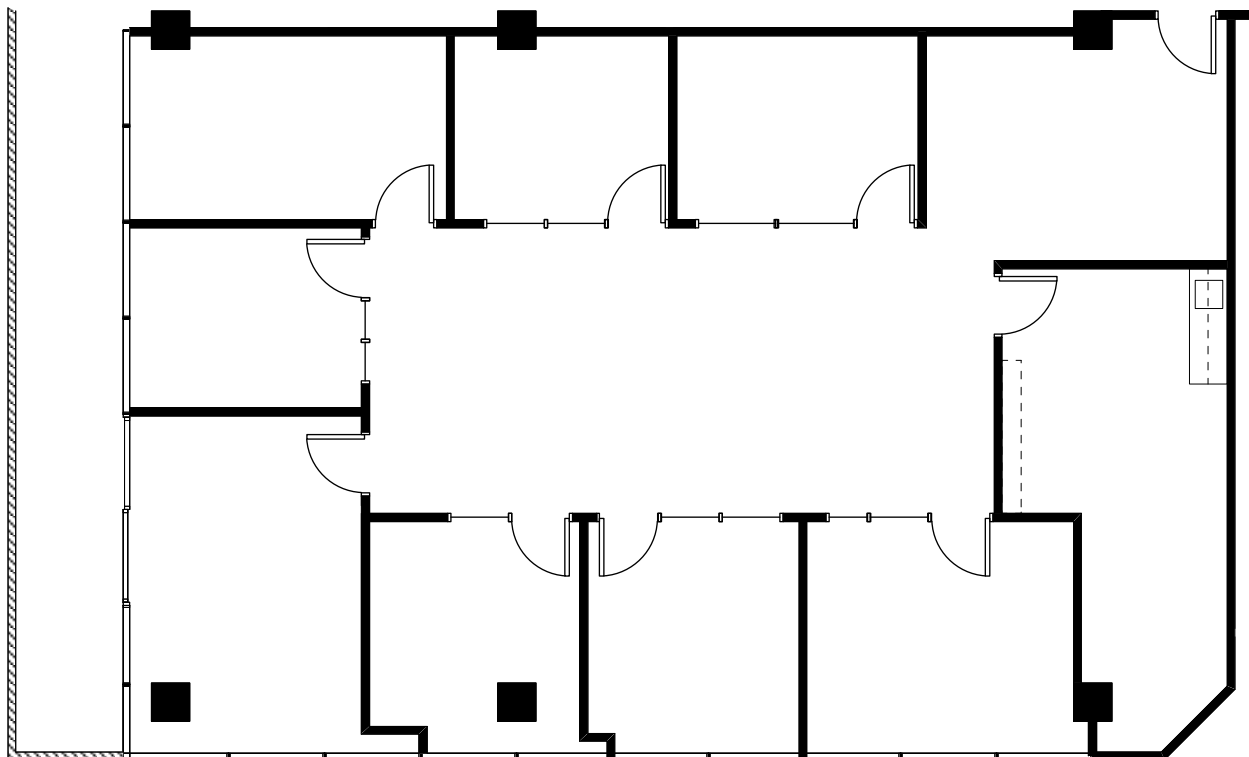

SUITES 380