



SUITE 220

SUITE FLOOR
LOCATION

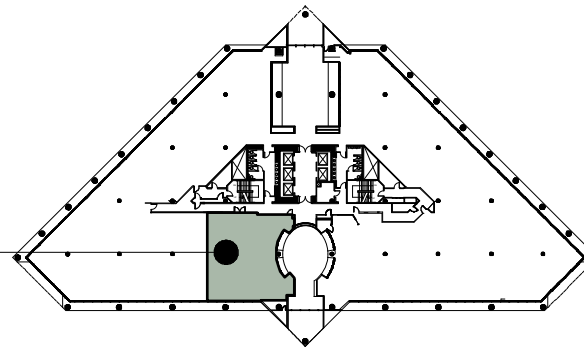

SECOND FLOOR KEY PLAN

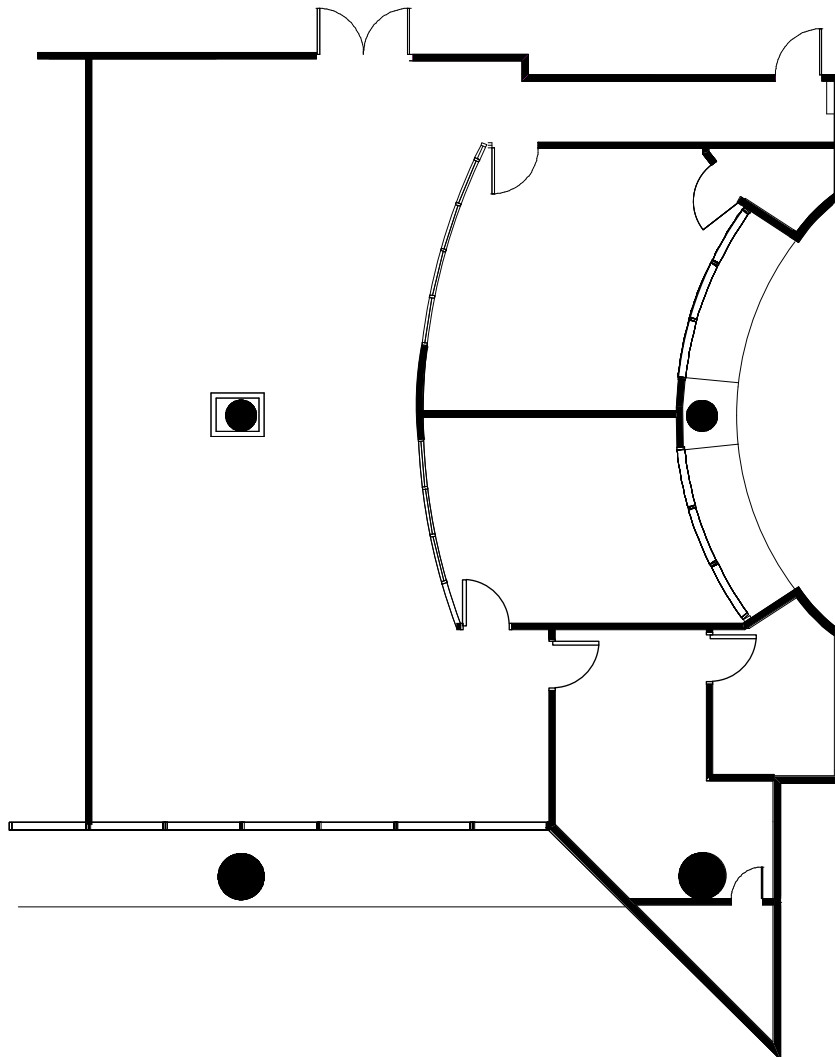

Colliers
INTERNATIONAL

Colliers International
1850 Mount Diablo Boulevard, Suite 200
Walnut Creek, CA 94596 | United States
www.colliers.com

LEASING AGENT

Scott Ellis
(925) 279-5575

scott.ellis@colliers.com

Matt Hurd
(925) 279-5567

matt.hurd@colliers.com

Eric Erickson
(925) 279-5580

eric.erickson@colliers.com

Concord Gateway II

1855 Gateway Blvd.
Concord, CA 94520

Second Floor

Owned and Managed by

**Sierra Pacific
Properties, Inc.**

Approximate Area Calculations
Subject To Verification:

2,670 rsf

As-built Plan To Be Verified

This information displayed while not guaranteed has
been secured by sources we believe to be reliable.
This information is subject to errors & omissions.
Any tenant should conduct their own investigation.

Plan Revision - 8-1-20