



Colliers International  
1850 Mount Diablo Boulevard, Suite 200  
Walnut Creek, CA 94596 | United States  
[www.colliers.com](http://www.colliers.com)

LEASING AGENT

**Scott Ellis**  
**(925) 279-5575**

[scott.ellis@colliers.com](mailto:scott.ellis@colliers.com)

**Matt Hurd**  
**(925) 279-5567**

[matt.hurd@colliers.com](mailto:matt.hurd@colliers.com)

## **Buskirk Executive Center**

2950 Buskirk Ave  
Walnut Creek, CA 94597

First Floor

Owned and Managed by

**Cranbrook  
Group, Inc.**


Approximate Area Calculations  
Subject To Verification:

1,775 rsf

**As-built Plan To Be Verified**


This information displayed while not guaranteed has been secured by sources we believe to be reliable. This information is subject to errors & omissions. Any tenant should conduct their own investigation.

Plan Revision - 4-12-23

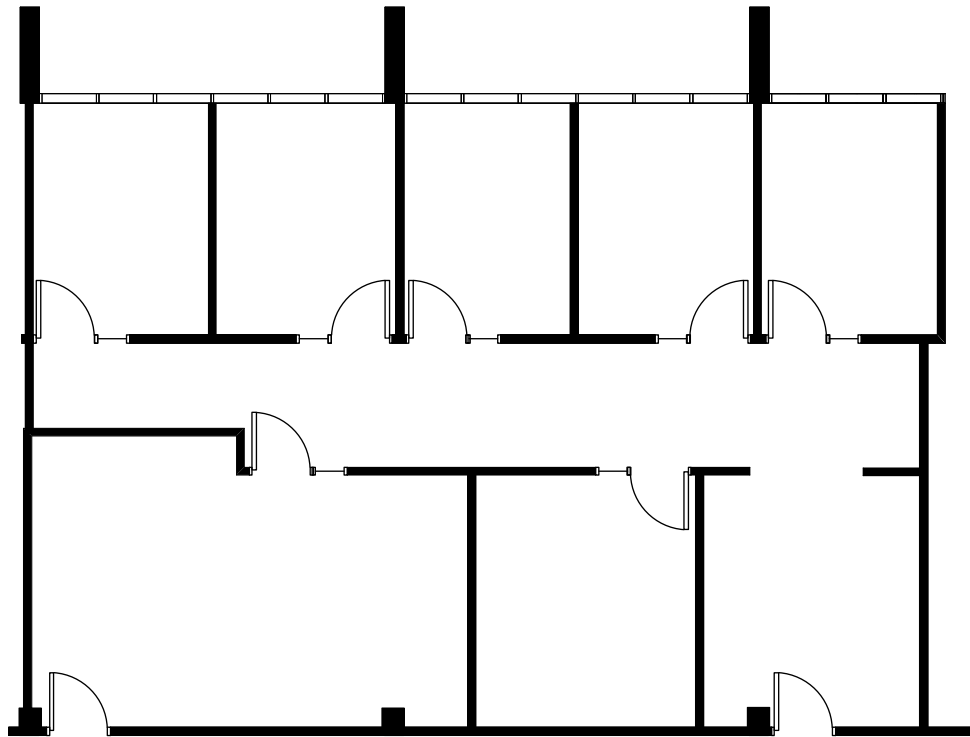

FLOOR LOCATION

**SUITE 140**

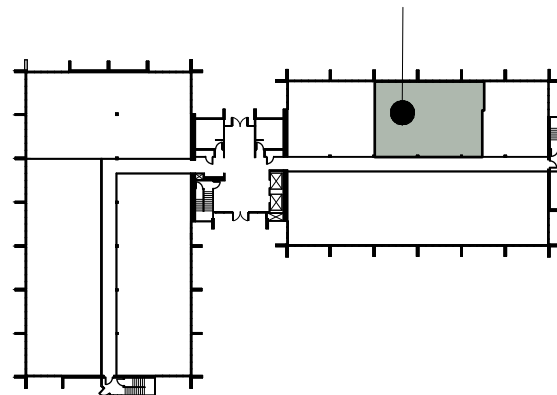

FIRST FLOOR KEY PLAN