

Colliers International  
1850 Mount Diablo Boulevard, Suite 200  
Walnut Creek, CA 94596 | United States  
www.colliers.com

LEASING AGENT

**Matt Hurd**  
(925) 279-5567

matt.hurd@colliers.com

**Scott Ellis**  
(925) 279-5575

scott.ellis@colliers.com

**1600**  
**South Main Plaza**  
Walnut Creek, CA

Third Floor

Managed by:

**WCSI**  
**Properties LLC**

Approximate Area Calculations  
Subject To Verification:

1,586 rsf


As-Built Plan To Be Verified

This information displayed while not guaranteed has been secured by sources we believe to be reliable.


This information is subject to errors & omissions. Any tenant should conduct their own investigation.

Plan Revision - 6-12-23

**SUITE 300**  
NORTH TOWER

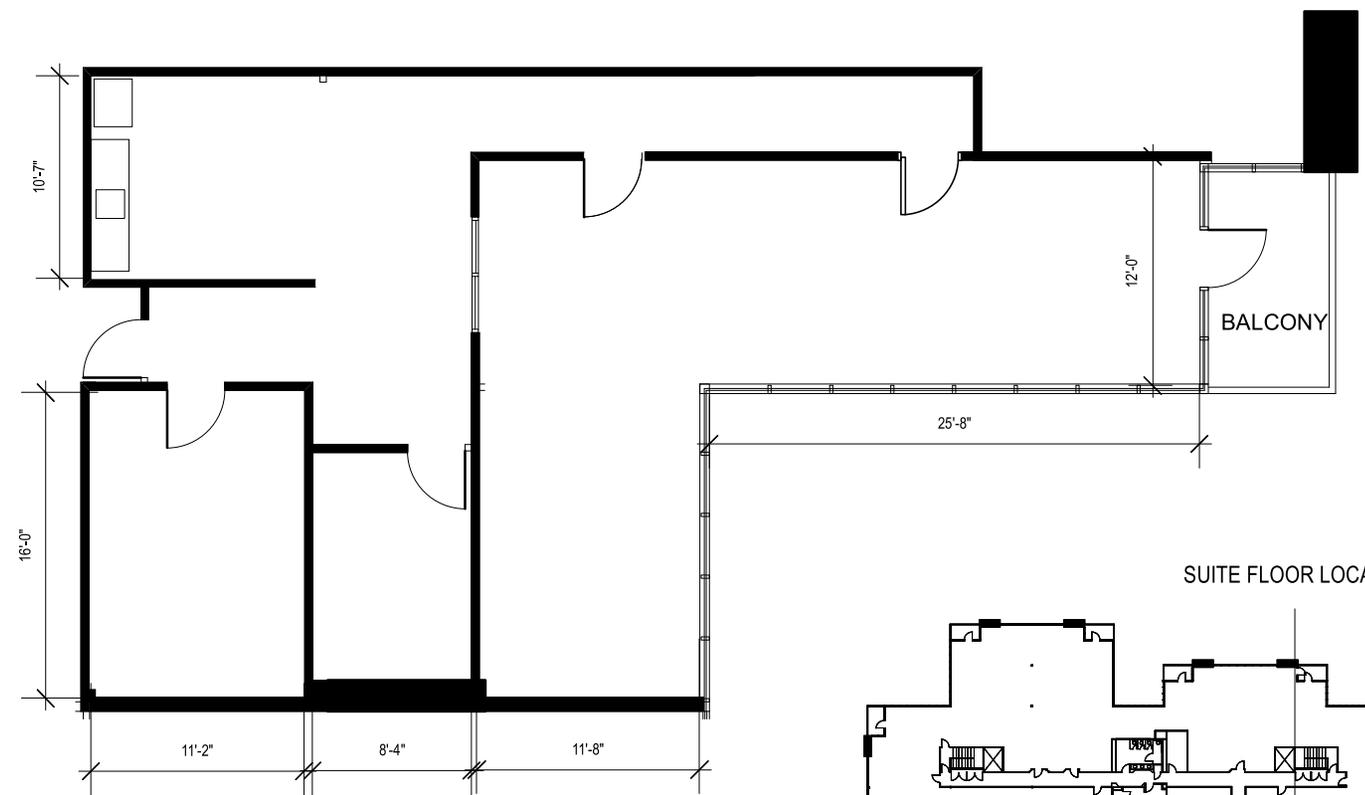

SUITE FLOOR LOCATION

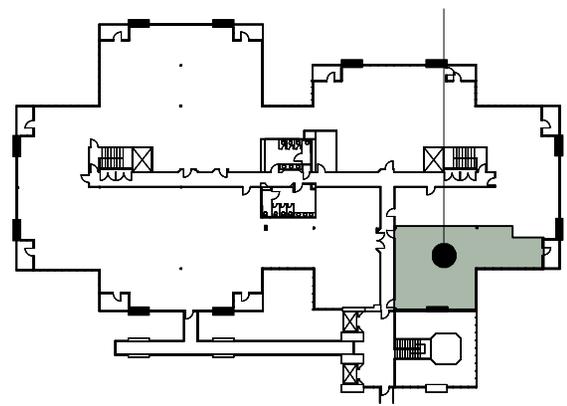

KEY PLAN NORTH BUILDING - FLOOR 3