



Colliers International
1850 Mount Diablo Boulevard, Suite 200
Walnut Creek, CA 94596 | United States
www.colliers.com

LEASING AGENT

Scott Ellis
(925) 279-5575

scott.ellis@colliers.com

Matt Hurd
(925) 279-5567

matt.hurd@colliers.com

Eric Erickson
(925) 279-5580

eric.erickson@colliers.com

Gateway Centre

1850 Mt. Diablo Blvd.
Walnut Creek, CA 94596

Third Floor

Owned and Managed by

**Sierra Pacific
Properties, Inc.**

Approximate Area Calculations
Subject To Verification:


3,719 RSF

As-built Plan To Be Verified


This information displayed while not guaranteed
has been secured by sources we believe to be
reliable.
This information is subject to errors & omissions.
Any tenant should conduct their own
investigation.

Plan Revision - 10-28-24

SUITE
LOCATION

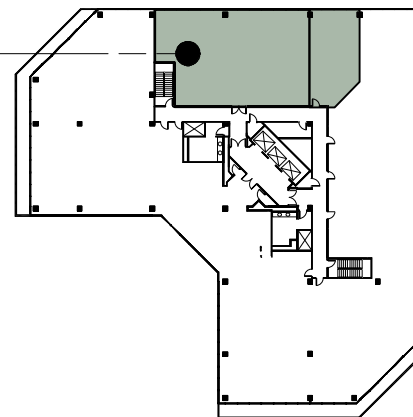

THIRD FLOOR KEY PLAN

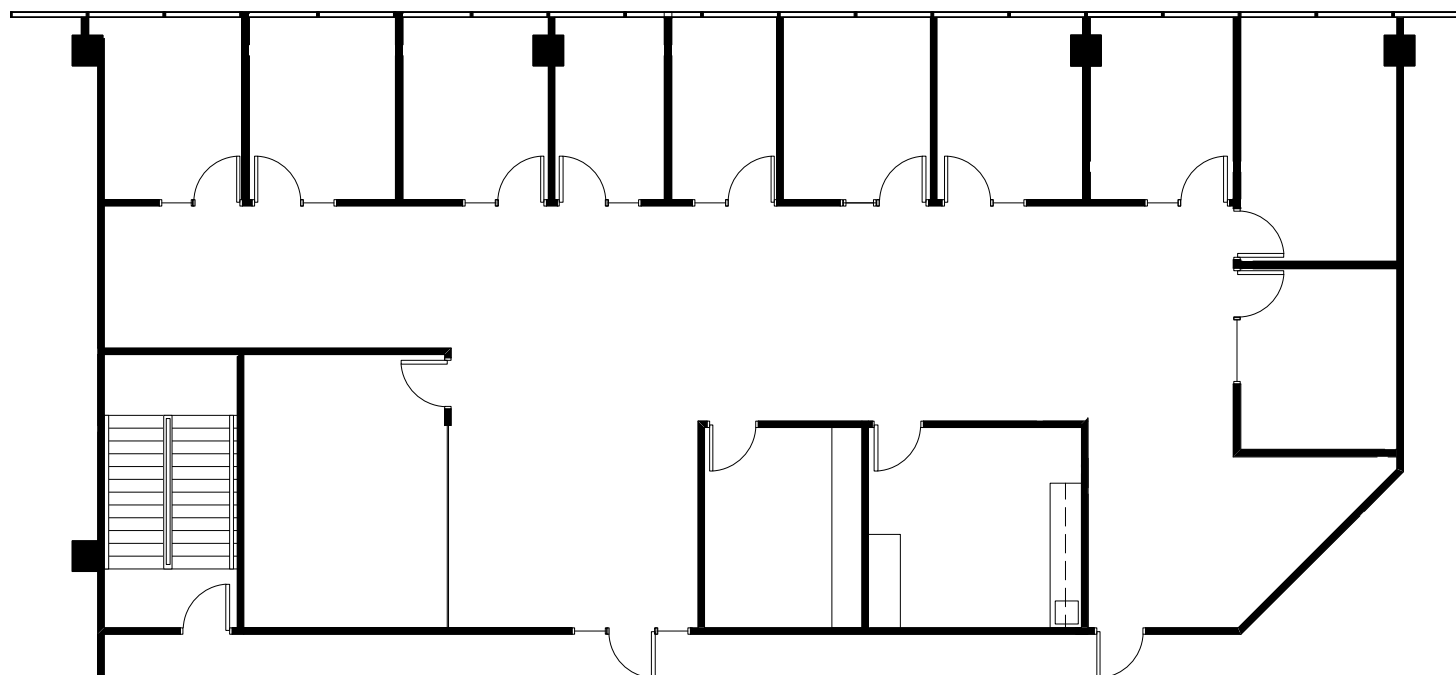

SUITE 340